


**Drawing Not to Scale**  
**All depths feet below ground surface**

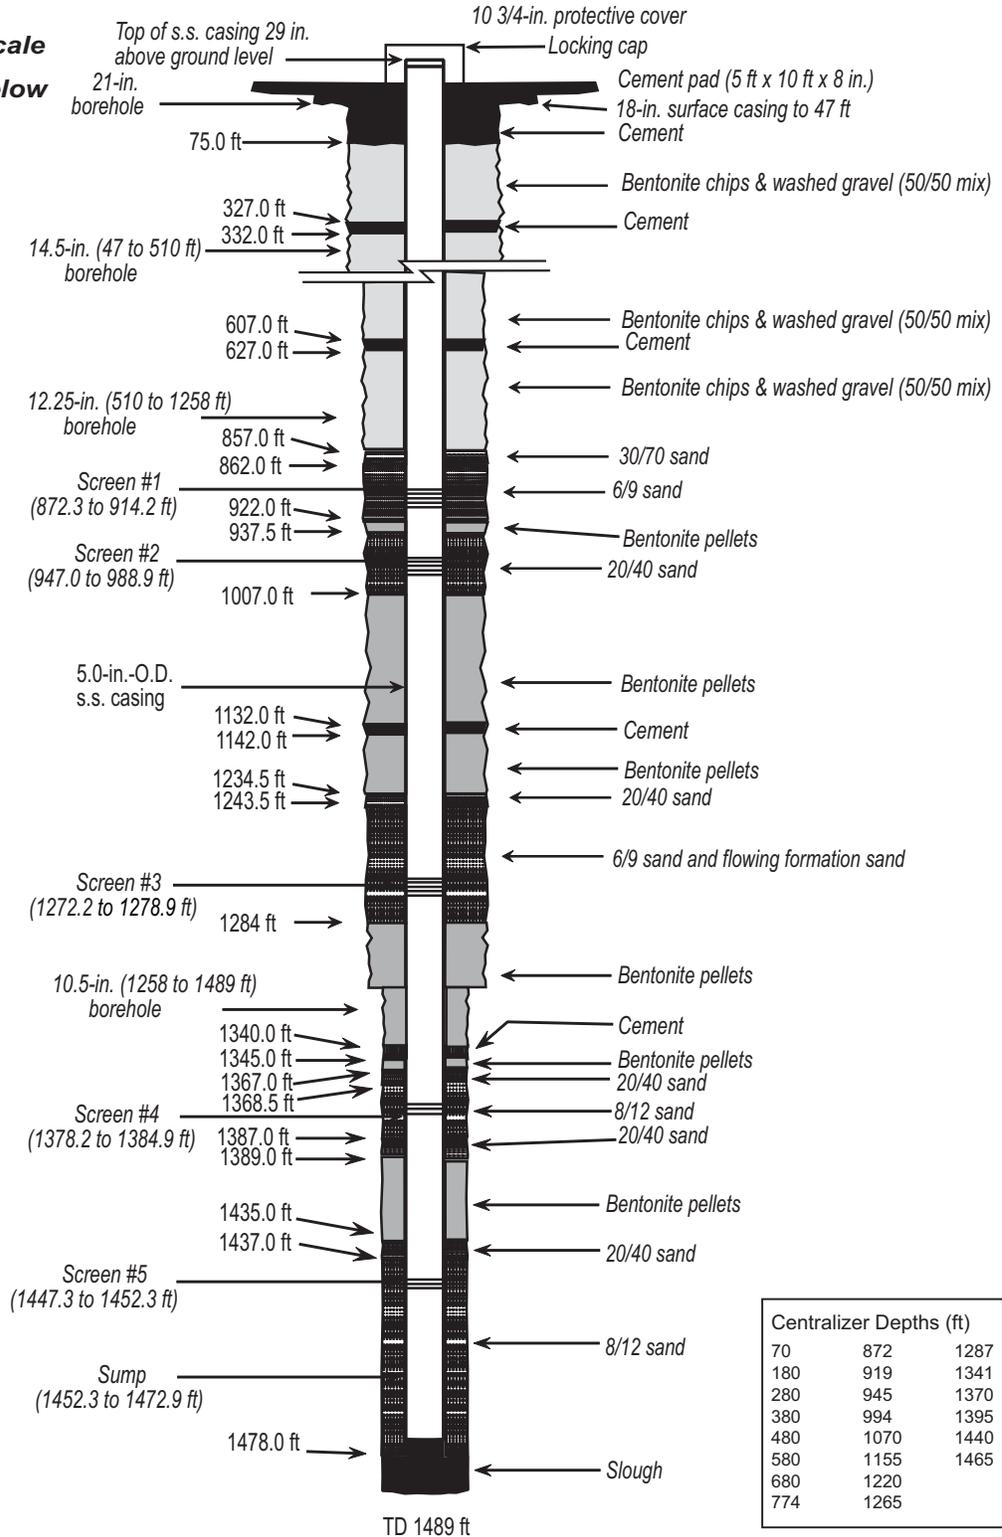

Note: The screen intervals list the footages of the pipe perforations, not the tops and bottoms of screen joints.

**Figure 4.2-1. As-built well configuration diagram, well R-22**