


- Notes: 1. The screen intervals list the footages of the pipe perforations, not the top and bottom of screen joints.
2. The formation slough around screen #1 consists of volcanoclastic sands and gravels.
3. Pipe-based screen: 5.56-in. O.D./ 4.5-in. I.D., 304 stainless steel with s.s. wire wrap; 0.010-in slots.

Figure 7.2-1. As-built configuration diagram of characterization well R-8 in BH2

Well Abandonment Diagram of Well R-8, Rev. 1 (05/22/02)

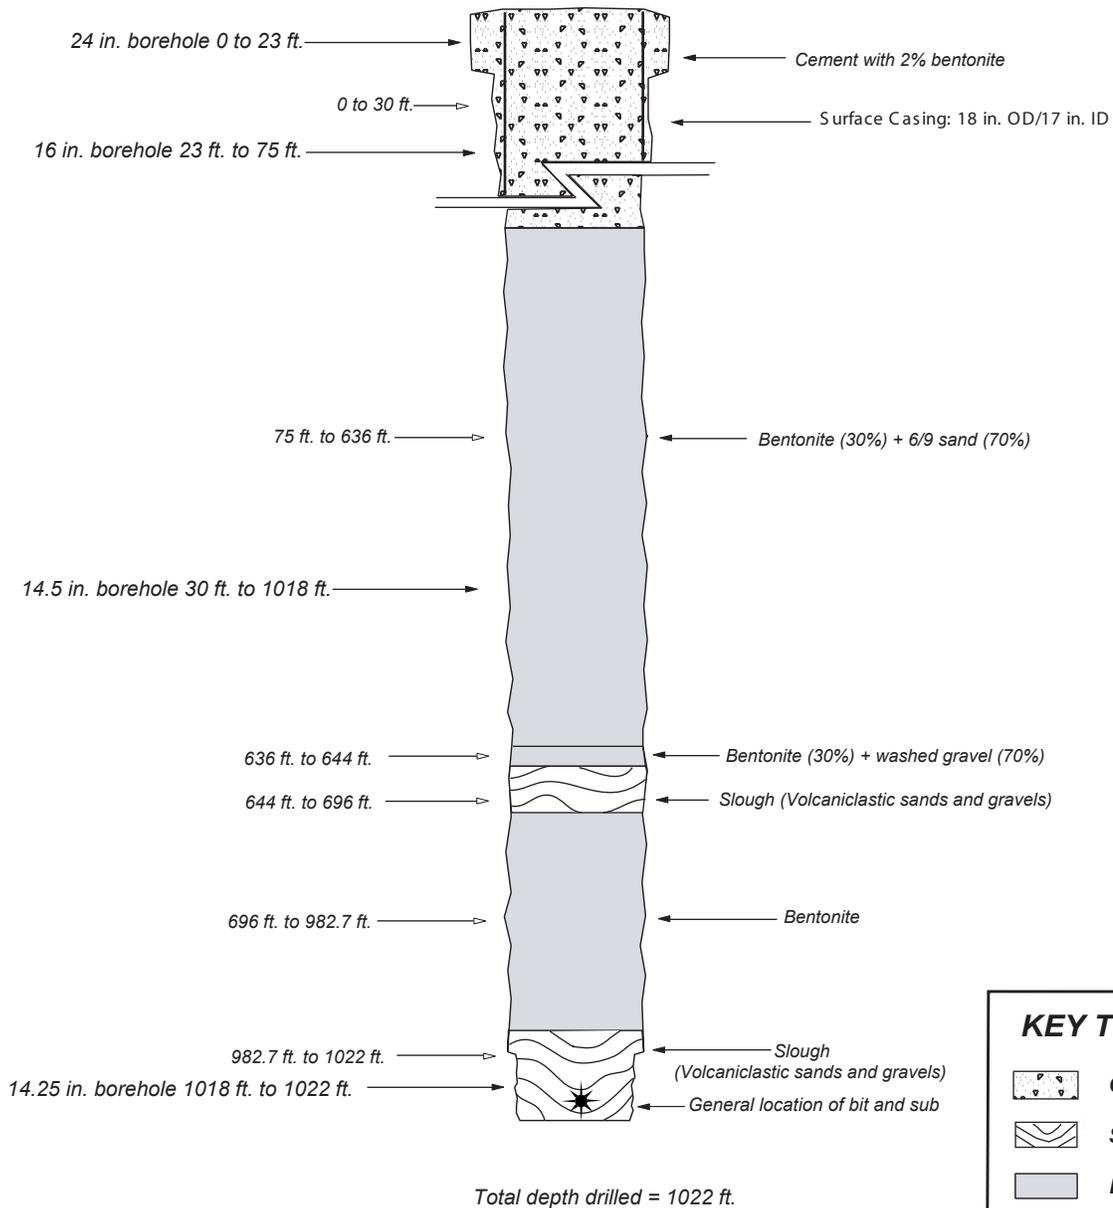

KEY TO MATERIALS USED

	Cement + bentonite (2%)
	Slough
	Bentonite

Note: Drawing Not to Scale
All depths are below ground surface