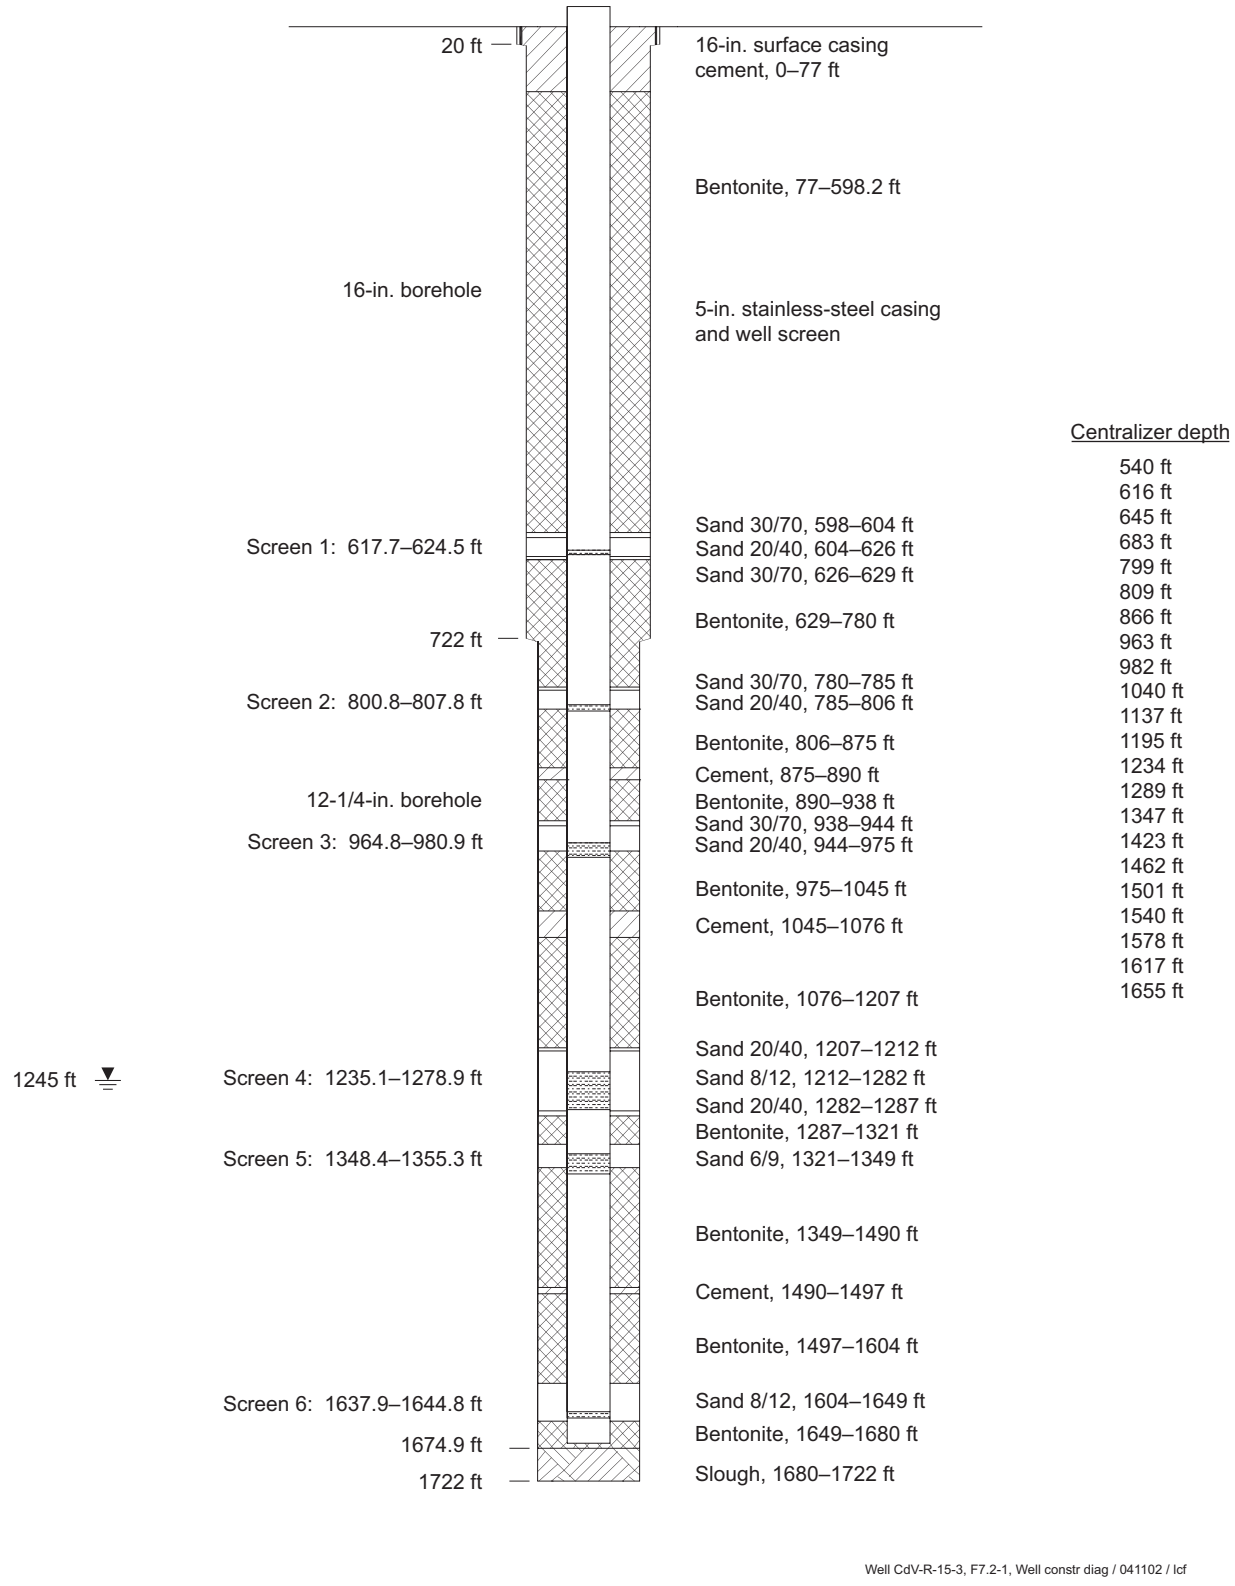

Figure 7.2-1. Well-construction diagram for CdV-R-15-3 (depth/thickness of annular fill material determined by wireline measurements)