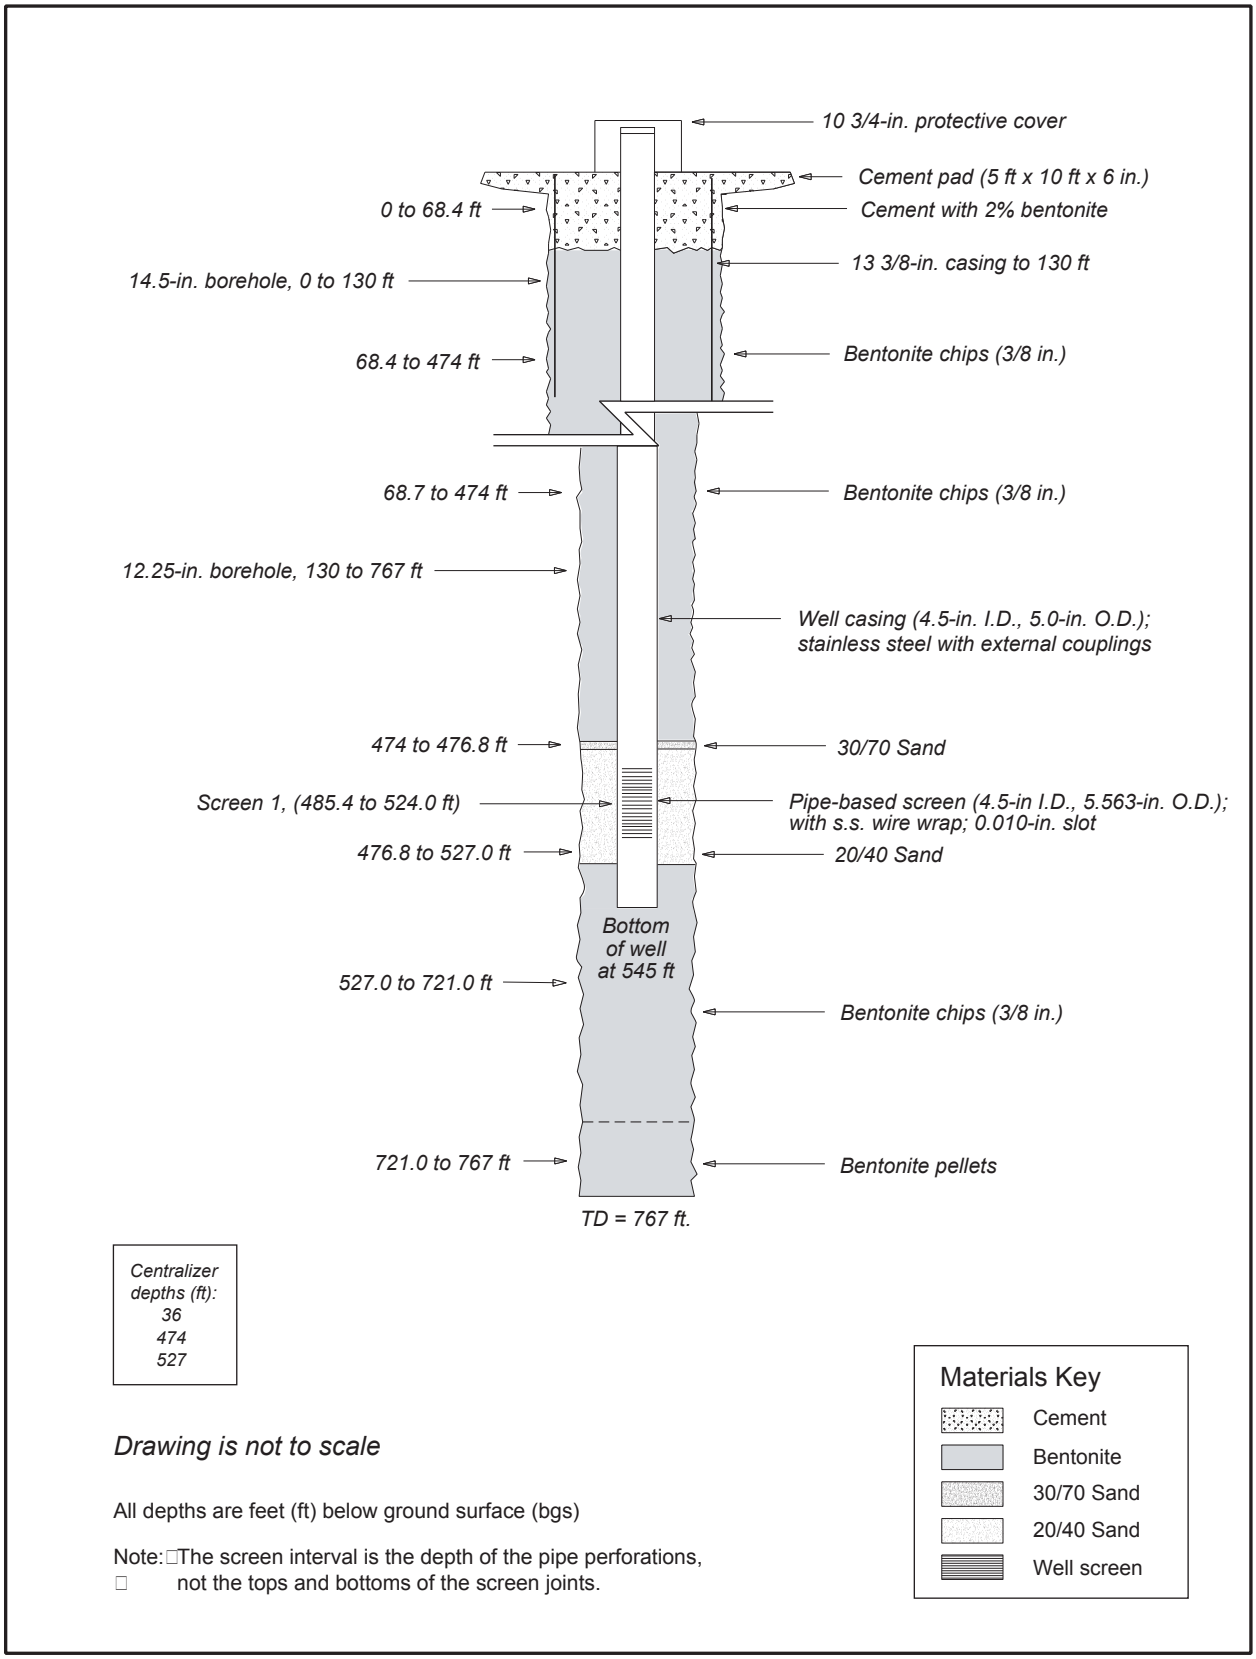

Figure 4.2-1 As-built well configuration diagram, Well MCOBT-4.4