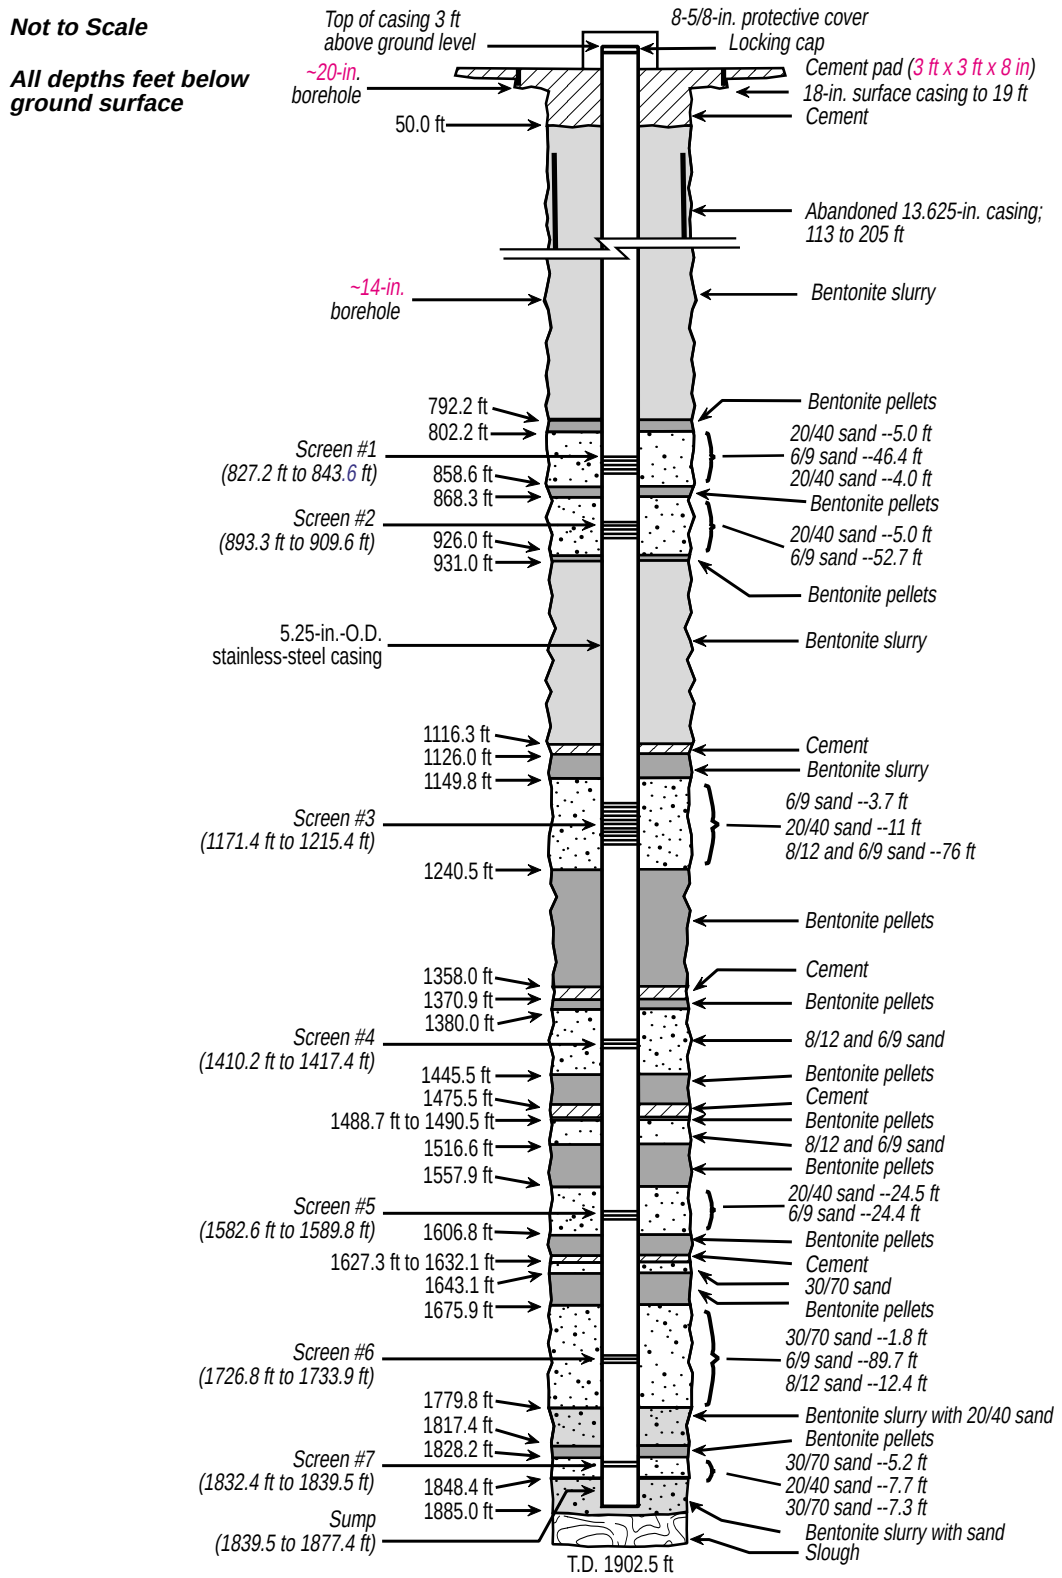

Note: The screen intervals list the footages of the pipe perforations, not the tops and bottoms of screen joints.

F8.2-1 / R-19 WELL COMPLETION RPT / 083000 / PTM

Figure 8.2-1. As-built well-completion diagram of well R-19